


EXISTING CONDITIONS

SCALE = 1:500

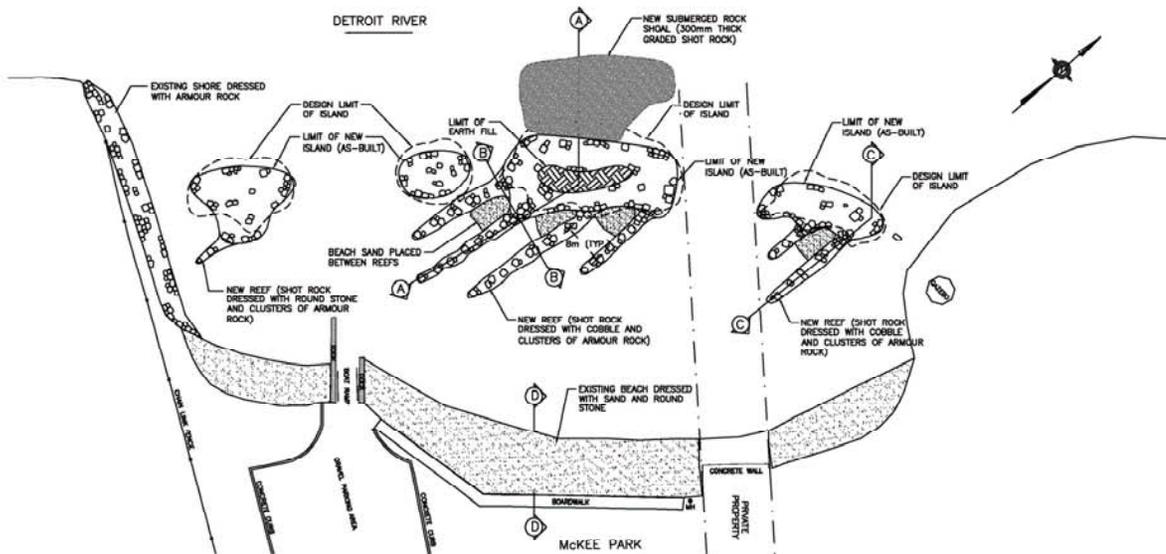

PROPOSED WORKS

SCALE = 1:500

AS-BUILT NOTES:

1. THE LOCATION OF THE NEW FEATURES AS INDICATED ON THIS DRAWING ARE BASED ON AN AS-BUILT SURVEY CONDUCTED BY HRYCAY CONSULTING ENGINEERS ON 3 APRIL 2003.
2. THE SECTIONS THROUGH THE NEW FEATURES ARE AS INDICATED ON THE DESIGN DRAWINGS.

BTS Consulting Engineers

1725 North Taber Road, R.R. #1
Windsor, Ontario, Canada N9A 6J3
Phone: (519) 737-7233
Fax: (519) 737-7203
MHR 633

Copyright reserved. This drawing is an instrument of service for the named consultant. The drawing and design are the exclusive property of BTS CONSULTING ENGINEERS and may not be used in whole or in part without the CONSULTANT'S written consent.

NOTE: THE CONSULTANT SHALL REVIEW AND REVIEW ALL CONDITIONS AND MEASUREMENTS SHOWN ON THIS DRAWING AND MAKE CORRECTIONS OCCUR HE SHALL REPORT TO THE ENGINEER FOR CLARIFICATION BEFORE PROCEEDING WITH ANY PORTION OF THE WORK IN THE CONTRACT.

| 6 | | |
|-----|---------------------|----------|
| 5 | | |
| 4 | | |
| 3 | AS-BUILT | APRIL 03 |
| 2 | REVISED LAYOUT | MARCH 03 |
| 1 | ISSUED FOR TENDER | JAN. 03 |
| 0 | ISSUED FOR APPROVAL | JAN. 03 |
| No. | Description | Date |

revision

date

AS-BUILT DRAWING

conditions

client
Eries Region Conservation Authority
Parks & Rec
WINDSOR

project
MCKEE PARK SHORELINE IMPROVEMENTS AND HABITAT ENHANCEMENT

drawing title
EXISTING CONDITIONS AND PROPOSED WORKS PLAN

| | | | |
|------------|----------------|-------------|---------|
| scale | AS SHOWN | approved by | |
| drawn by | DAVID ANDERSON | project no. | M232 |
| date | 12/02 | designed by | DMK |
| checked by | DMK | date | 11/02 |
| date | | drawing no. | M232-01 |
| | | sheet no. | 1 of 2 |

all dimensions are in METRES